Oversize
TN
434
.Y8
.K4
.K33
2009
Vol. 4


ELSA, YUKON

Volume 4


HERITAGE RECORD

As-found Location: 700 kilometres (435 miles) to the North of Whitehorse, at Mile 60.3 of the Silver Trail, Yukon Highway 11

September 28, 2009

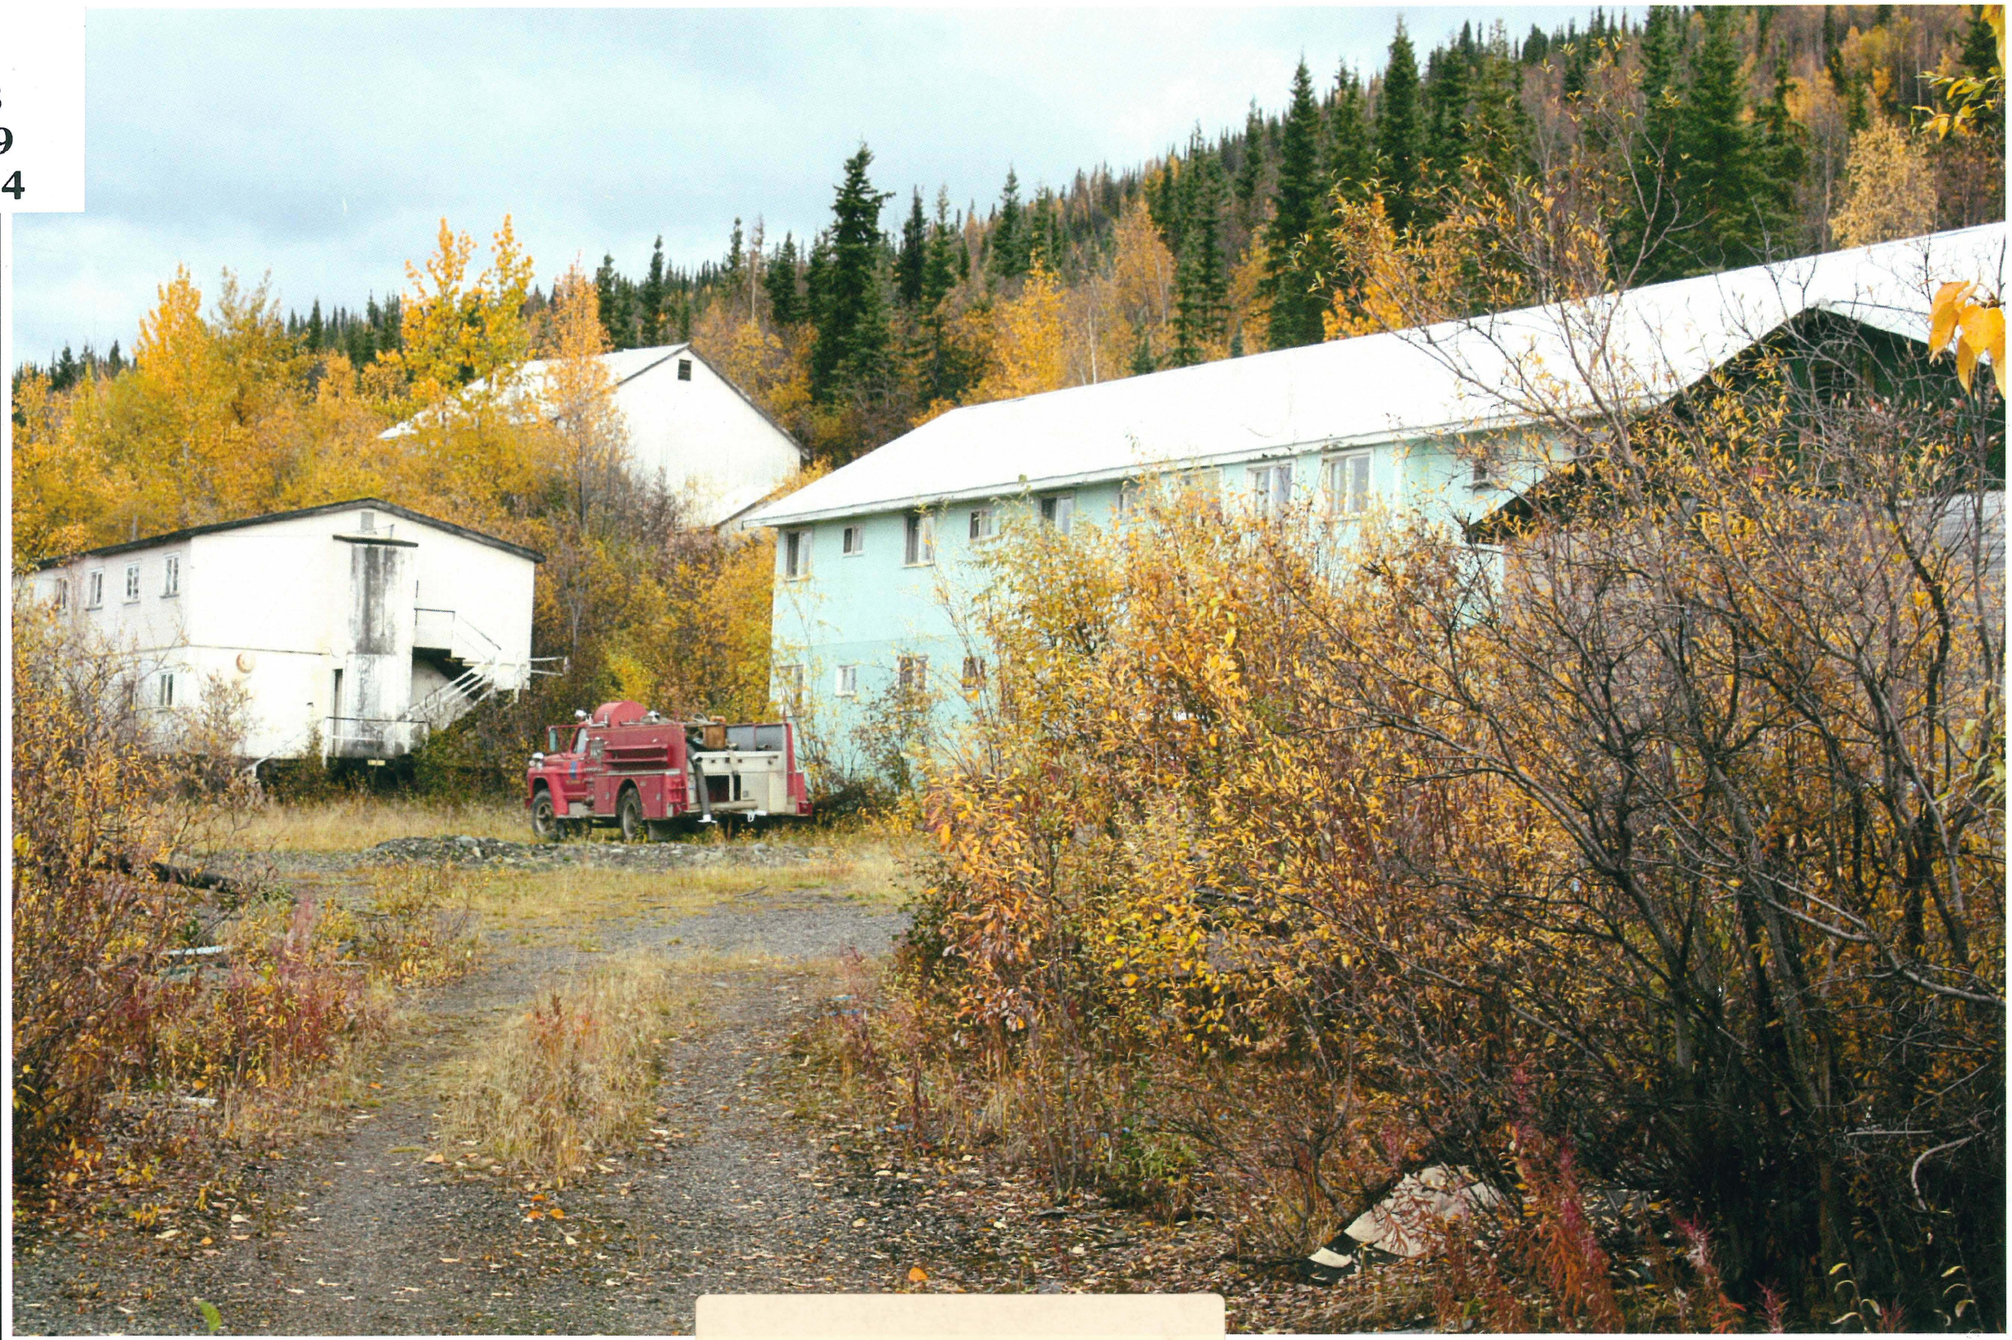

NOTES/REFERENCE DRAWINGS

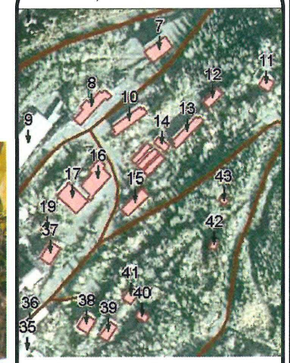

SITE LAYOUT - KEY

K.D. Drafting Ltd.
HERITAGE RECORDING
10815 - 128 STREET
EDMONTON ALBERTA CANADA
T5M 0W3
PHONE/FAX: 780.454.5155 C 238.5155
E-MAIL: kddrafting@telus.net

REVISIONS & ISSUES

NO.	DATE	DESCRIPTION	BY
01	09/24/09	ISSUED FOR REVIEW	KD

FIELD NOTES TAKEN
September 2009

DRAWN
K. Dombrosky

CHK'D
B. Hogan

SCALE:
HOR.
VER.

Yukon
Tourism and Culture
Historic Sites Unit

ELSA

GENERAL INFORMATION SHEET

PHOTOGRAPHIC COVER SHEET

Sheet
OF

Consultant Dwg No.: A0.1

Y.T.G. Drawing No.:

REV.

Filename: D:\Delo\Ketchi\ Site Current Work (KD01)\1-Ketchi Sites Word documents\09-Sites_Yukon - 2009\November 7-09 Final Submittal\1-Elsa Sheets-ZW0 format- November 7-09\01-Elsa A0-1 and A0-2.dwg Date: 11/7/2009

UK-44-R85

YUKON ENERGY, MINES
& RESOURCES LIBRARY
P.O. Box 2703 (K-335)
Whitehorse, Yukon Y1A 2C6

ELSA, YUKON

HERITAGE RECORD

As-found Location: 700 kilometres (435 miles) to the North of Whitehorse, at Mile 60.3 of the Silver Trail, Yukon Highway 11

September 28, 2009

LIST OF DRAWINGS

NUMBER OF SHEETS	DRAWING NUMBER	DESCRIPTION
	A0 Series	General Information
1	A0.1	PHOTOGRAPHIC COVER SHEET
2	A0.2	LIST OF DRAWINGS, SYMBOLS, LEGEND
	A1 Series	Site Plans
3	A1.1	SITE PLAN – KEY – AERIAL
4	A1.2	SITE PLAN – ENLARGED
	A2 Series	Floor Plans
5	A2.12	BUILDING #12 – 1st FLOOR PLAN
	A3 Series	Exterior Elevations
6	A3.7	BUILDING #7 – NEW BUNKHOUSE
7	A3.8	BUILDING #8 – GEOLOGY OFFICE
8	A3.10	BUILDING #10 – NO. 5 BUNKHOUSE
9	A3.11	BUILDING #11 – UTILITY BUILDING
10	A3.12	BUILDING #12 – BUNKHOUSE
11	A3.13	BUILDING #13 – NO. 1 BUNKHOUSE
12	A3.14	BUILDING #14 – UNION SHOP
13	A3.15	BUILDING #15 – SNACK BAR
14	A3.16	BUILDING #16 – DINING HALL
15	A3.17	BUILDING #17 – DRY / CHANGE BUILDING
16	A3.19	BUILDING #19 – FIRE ASSAY OFFICE
17	A3.37	BUILDING #37 – ASSAY LAB
18	A3.38	BUILDING #38 – ADMINISTRATION
19	A3.39	BUILDING #39 – STAFF OFFICE
20	A3.40	BUILDING #40 – GARAGE
21	A3.41	BUILDING #41 – APARTMENT
22	A3.42	BUILDING #42 – GARAGE
23	A3.43	BUILDING #43 – CHURCH
23		TOTAL NUMBER OF HERITAGE RECORD DRAWINGS

LEGEND

GENERAL

ALL DIMENSIONS ARE IMPERIAL AND METRIC MEASUREMENTS

OBJECT LINE

HIDDEN, ASSUMED OR INTERPRETED LINE

PLAN NORTH

NOTE REFERENCE SYMBOL

1 GENERAL NOTE REFERENCE

1 IF THE NOTE REFERS TO A SPECIFIC POINT THEN THE CORNER IS BLACKENED IN

REFERENCE SYMBOLS

A / B C DESCRIPTION
SCALE:

A / B C

A – SECTION NUMBER
B – SHEET NUMBER WHERE DETAIL IS REFERENCED FROM
C – SHEET NUMBER WHERE DETAIL IS DRAWN

ROOM 101 ROOM REFERENCE SYMBOL
- ROOM NUMBER
- FLOOR NUMBER
- ROOM NAME

W101 WINDOW REFERENCE SYMBOL
- WINDOW NUMBER
- FLOOR NUMBER
- WINDOW

D101 DOOR REFERENCE SYMBOL
- DOOR NUMBER
- FLOOR NUMBER
- DOOR

FLOOR DESIGNATIONS
- B– LOWER FLOOR
- 1– MAIN FLOOR
- 2– UPPER FLOOR
- A– ATTIC

MATERIALS

EARTH

WOOD SHINGLES

ORIGINAL LUMBER

FINISHED WOOD

MODERN LUMBER

PHOTO SYMBOLS

35mm PHOTOGRAPHY

PHOTOGRAPH NUMBER

CAMERA LOOKING UP

DIRECTION PHOTO TAKEN


CAMERA LOOKING DOWN

CAMERA HORIZONTAL

CAMERA LOOKING STRAIGHT DOWN

CAMERA LOOKING STRAIGHT UP

NOTES/REFERENCE DRAWINGS

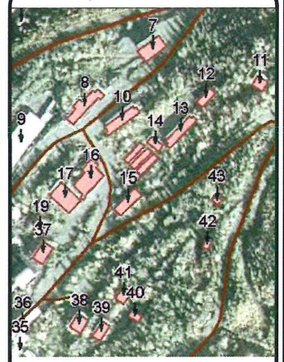

SITE LAYOUT - KEY

K.D. Drafting Ltd.
HERITAGE RECORDING
10815 – 128 STREET
EDMONTON ALBERTA CANADA
T5M 0W3
PHONE/FAX: 780.454.5155 C 238.5155
E-MAIL: kddrafting@telus.net

REVISIONS & ISSUES

NO.	DATE	DESCRIPTION	BY
01	09/24/09	ISSUED FOR REVIEW	KD

FIELD NOTES TAKEN
September 2009

DRAWN K. Dombrosky
CHK'D B. Hogan
SCALE:
HOR.
VER.

Yukon
Tourism and Culture
Historic Sites Unit

ELSA


GENERAL INFORMATION SHEET

LIST OF DRAWINGS SYMBOLS, LEGEND

Sheet
OF
Consultant Dwg No.: A0.2
Y.T.G. Drawing No.:
REV.

Filename: D:\Data\Historic Site Current Work (YDOT)\1-Historic Sites Word documents\26-Elsa, Yukon - 2009\November 7-09 Final Submittal\1-Elsa Sheets-DWG format- November 7-09\01-Elsa A0s1 and A0.2.dwg Date: 11/7/2009

AREA OF SCOPE OF WORK (A1.2)

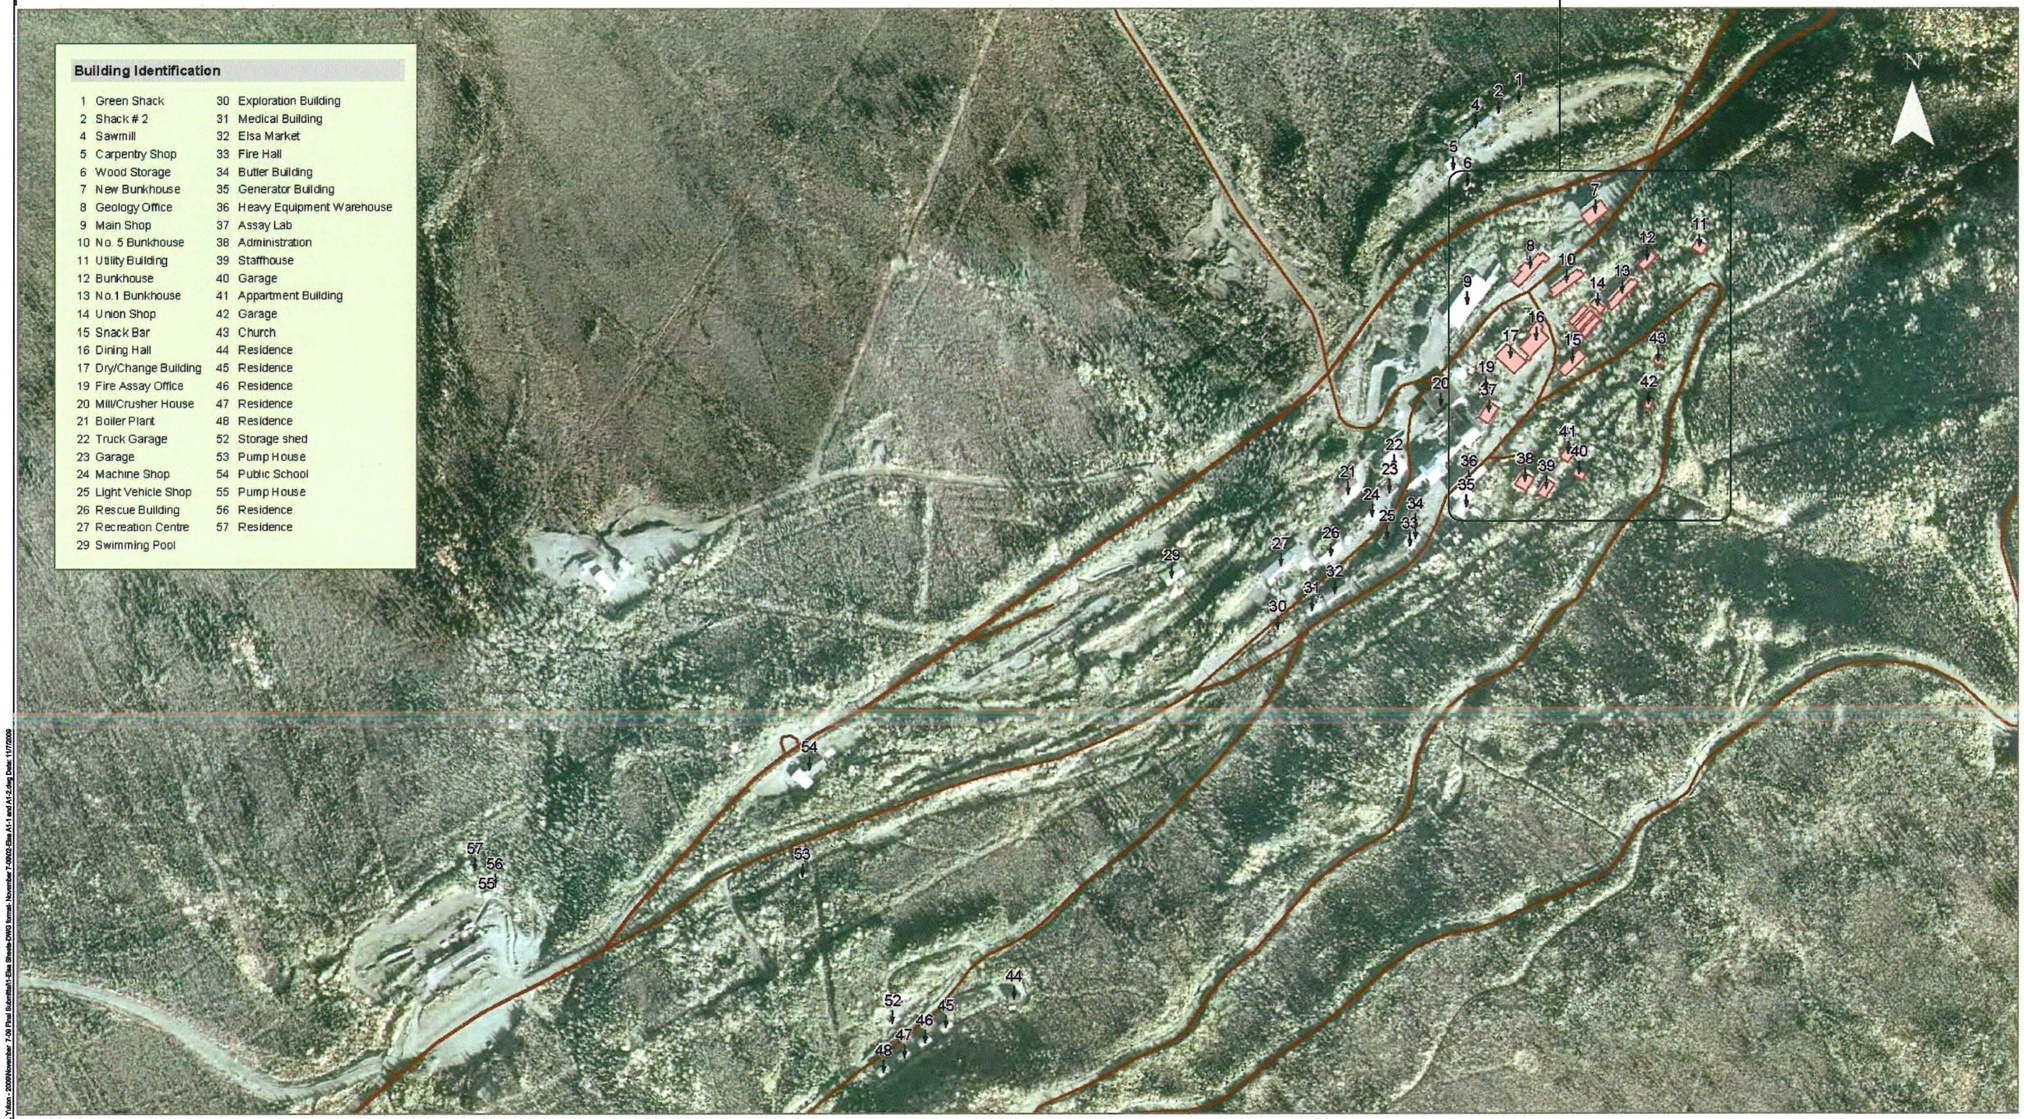

Building Identification

1	Green Shack	30	Exploration Building
2	Shack # 2	31	Medical Building
4	Sawmill	32	Elsa Market
5	Carpentry Shop	33	Fire Hall
6	Wood Storage	34	Butler Building
7	New Bunkhouse	35	Generator Building
8	Geology Office	36	Heavy Equipment Warehouse
9	Main Shop	37	Assay Lab
10	No. 5 Bunkhouse	38	Administration
11	Utility Building	39	Staffhouse
12	Bunkhouse	40	Garage
13	No.1 Bunkhouse	41	Appartment Building
14	Union Shop	42	Garage
15	Snack Bar	43	Church
16	Dining Hall	44	Residence
17	Dry/Change Building	45	Residence
19	Fire Assay Office	46	Residence
20	Mill/Crusher House	47	Residence
21	Boiler Plant	48	Residence
22	Truck Garage	52	Storage shed
23	Garage	53	Pump House
24	Machine Shop	54	Public School
25	Light Vehicle Shop	55	Pump House
26	Rescue Building	56	Residence
27	Recreation Centre	57	Residence
29	Swimming Pool		

1:5,600

National Topographic Data Base (NTDB) compiled by Natural Resources Canada at a scale of 1:50,000. Cadastral data compiled by Natural Resources Canada. Reproduced under license from © Her Majesty the Queen in Right of Canada, Department of Natural Resources Canada. All rights reserved.

Projection: UTM Zone 8 NAD83
NTS Sheet 105M/13 and 105M/14

0 62.5 125 250 375 500 625 Meters


Physical Hazard Reduction - 2009

ERDC

ACCESS CONSULTANTS GROUP

SITE PLAN - KEY (A1.1)
SCALE: NTS

NOTES/REFERENCE DRAWINGS

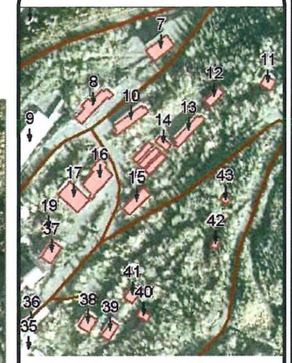

SITE LAYOUT - KEY

K.D. Drafting Ltd.
HERITAGE RECORDING
10815 – 129 STREET
EDMONTON ALBERTA CANADA
T5M 0W3
PHONE/FAX: 780.454.5155 C 238.5155
E-MAIL: kddrafting@telus.net

REVISIONS & ISSUES

NO.	DATE	DESCRIPTION	BY
01	09/24/09	ISSUED FOR REVIEW	KD

FIELD NOTES TAKEN: September 2009
DRAWN: K. Dombrosky
CHK'D: B. Hogan
SCALE: HOR. VER.

Yukon
Tourism and Culture
Historic Sites Unit

ELSA
BUILDING LOCATIONS

SITE PLAN

ELSA PHYSICAL HAZARD REDUCTION PLAN
FIGURE 2
BUILDING LOCATION

Drawn By: MD	Checked by: KN	July 2009

D:\Project\AllProjects\ALEX-05-01\gis\mxd\UKHM\Physical_Hazard_Reduction\2009\Figure_2_Building_Locations.mxd

Sheet OF

Consultant Dwg No.: A1.1

Y.T.G. Drawing No.: REV.

Plotted: D:\Data\Historic Site Current Work (KD01\1-Historic Sites Work documents\Site Visits - 2009\November 7-09 Final Submittal\1-Site Sheets-DWG format - November 7-09\02-Site A1-1 and A1-2.dwg Date: 11/7/2009

BUILDING IDENTIFICATION


BUILDING # - BUILDING NAME

BUILDING #7 - NEW BUNKHOUSE
BUILDING #8 - GEOLOGY OFFICE
BUILDING #10 - NO. 5 BUNKHOUSE
BUILDING #11 - UTILITY BUILDING
BUILDING #12 - BUNKHOUSE
BUILDING #13 - NO. 1 BUNKHOUSE
BUILDING #14 - UNION SHOP
BUILDING #15 - SNACK BAR
BUILDING #16 - DINING HALL
BUILDING #17 - DRY / CHANGE BUILDING
BUILDING #19 - FIRE ASSAY OFFICE
BUILDING #37 - ASSAY LAB
BUILDING #38 - ADMINISTRATION
BUILDING #39 - STAFF OFFICE
BUILDING #40 - GARAGE
BUILDING #41 - APARTMENT
BUILDING #42 - GARAGE
BUILDING #43 - CHURCH

LEGEND




BUILDING LOCATION AND BUILDING NUMBER

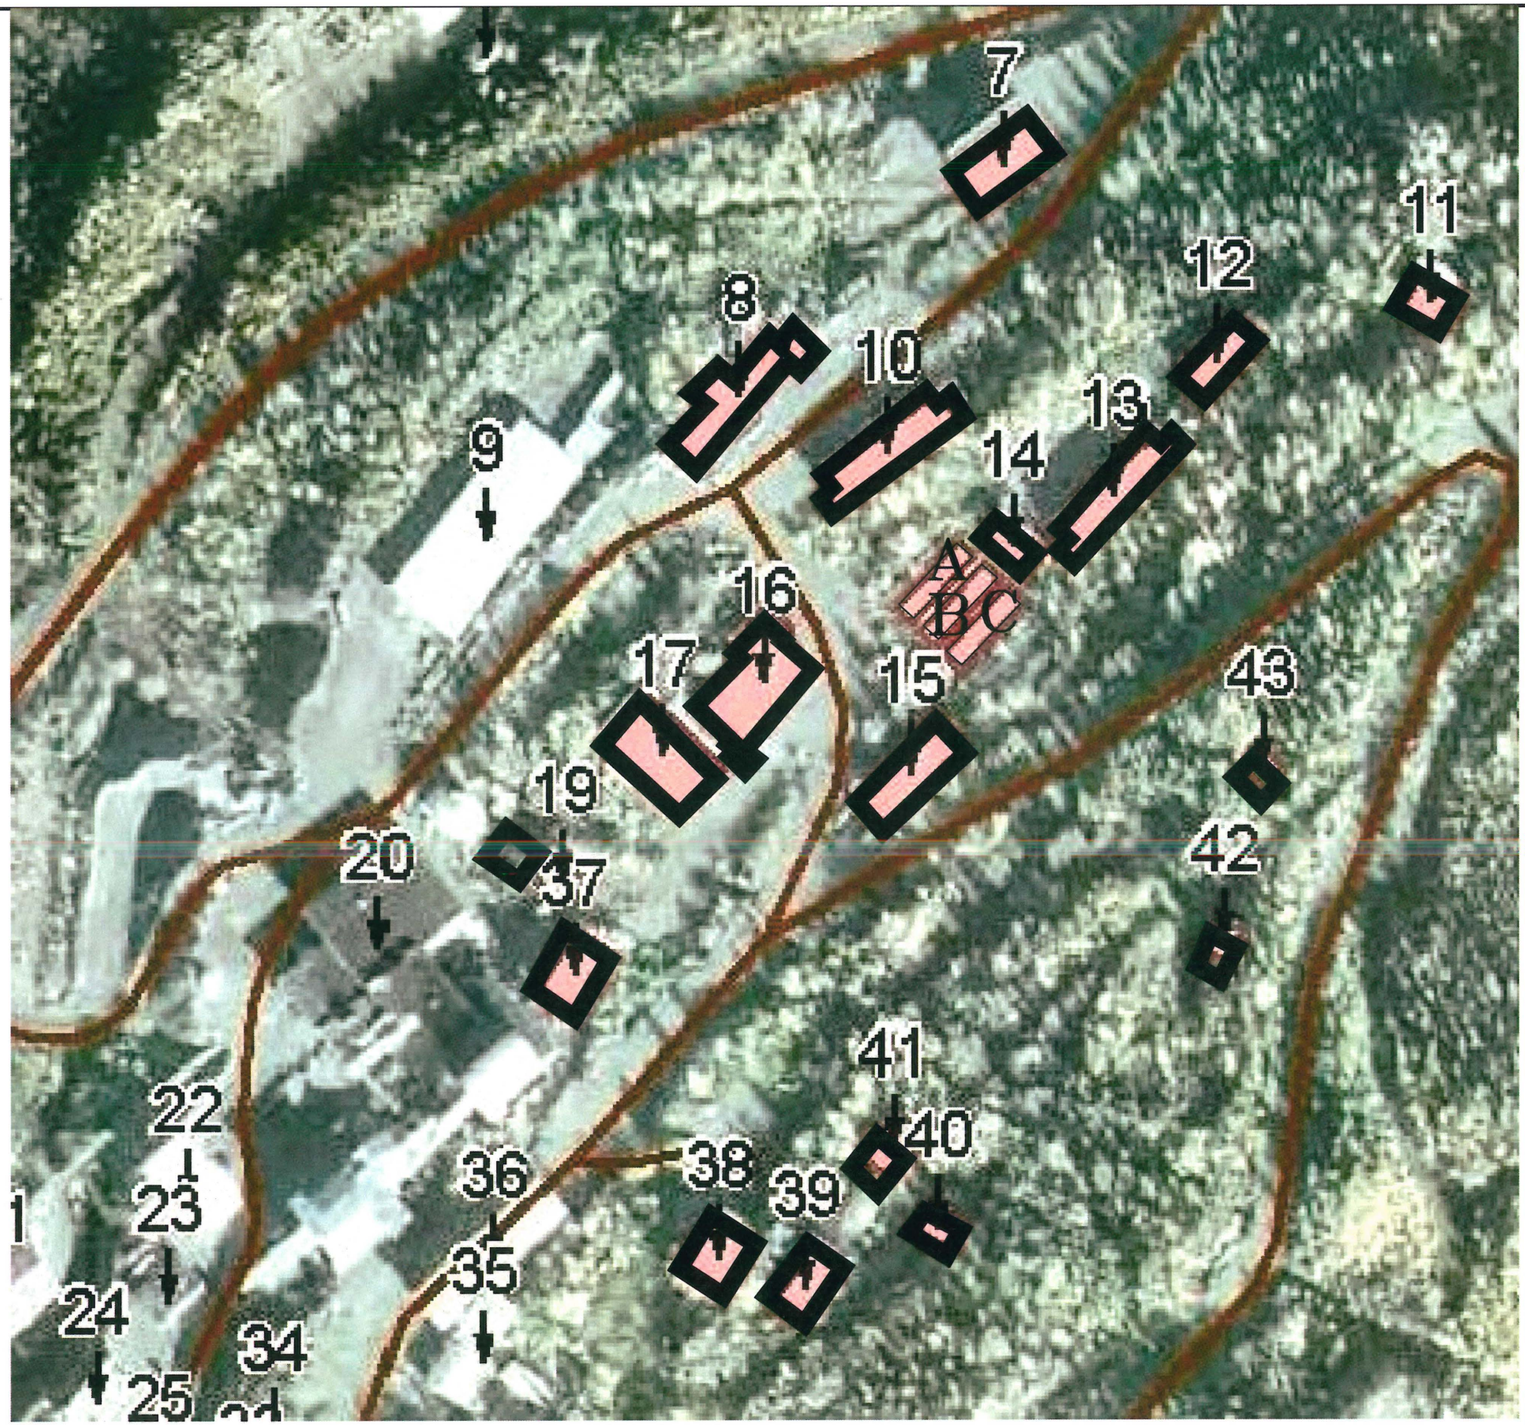

SITE PLAN - ENLARGEMENT
SCALE: NTS

NOTES/REFERENCE DRAWINGS

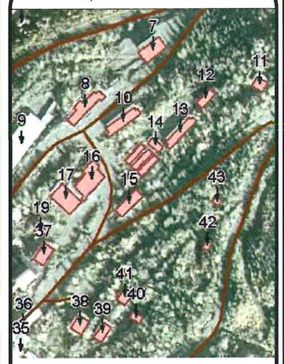

SITE LAYOUT - KEY

K.D. Drafting Ltd.
HERITAGE RECORDING
10815 - 128 STREET
EDMONTON ALBERTA CANADA
T5M 0W3
PHONE/FAX: 780.454.5155 C 238.5155
E-MAIL: kddrafting@telus.net

REVISIONS & ISSUES

NO.	DATE	DESCRIPTION	BY
01	09/24/09	ISSUED FOR REVIEW	KD

FIELD NOTES TAKEN
September 2009

DRAWN K. Dombrosky
CHK'D B. Hogan
SCALE:
HOR.
VER.

Yukon
Tourism and Culture
Historic Sites Unit

ELSA

BUILDING LOCATIONS


SITE PLAN ENLARGEMENT

Sheet
OF

Consultant Dwg No.: A1.2


Y.T.G. Drawing No.: REV.

Plotted: D:\Data\Admin Do Current Work\2009\15 Hacks (Ben Ward documents)\Dr. Yukon - 2009\November 24\Plot Submittal\1 Dwg Sheets\November 24\2009_Elsa_A1.1 and A1.2.dwg Date: 11/7/2009

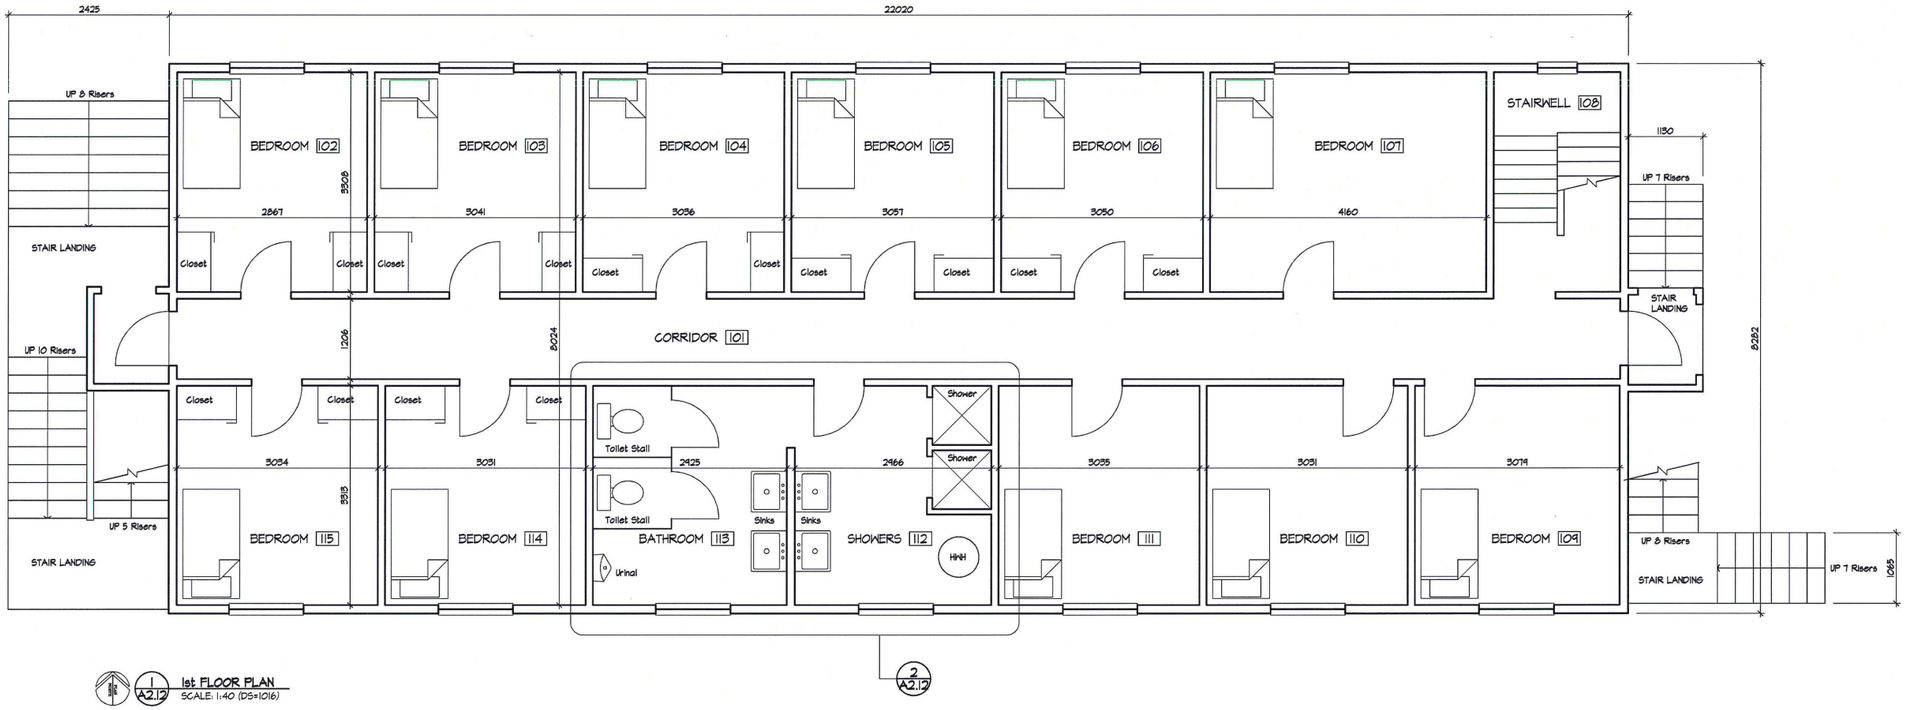

1 / A2.12 **1st FLOOR PLAN**
SCALE: 1:40 (DS=1016)

2 / A2.12

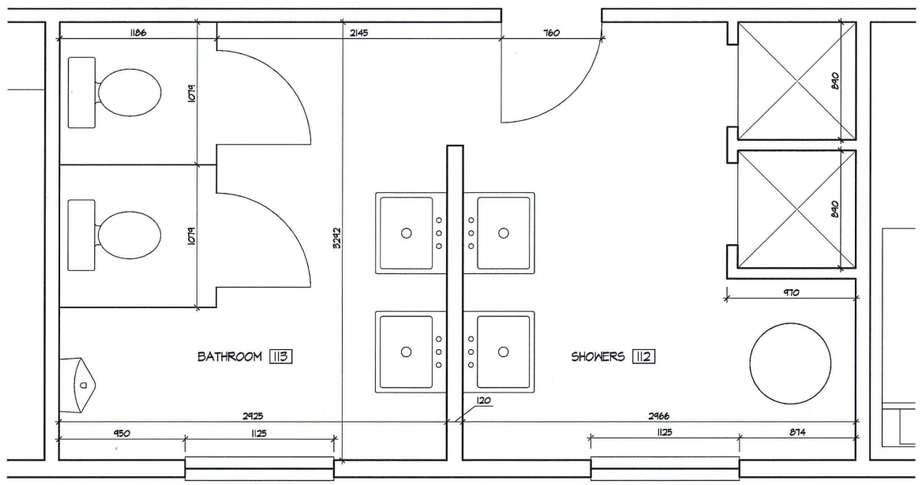


2 / A2.12 **ENLARGED BATHROOM LAYOUT**
SCALE: 1:20



3 / A2.12 **NORTH EXTERIOR ELEVATION**
SCALE: NTS

NOTES/REFERENCE DRAWINGS

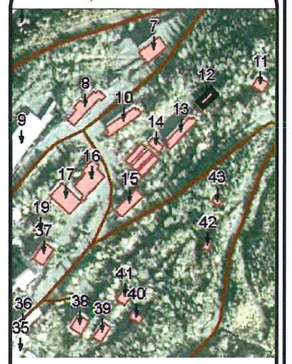

SITE LAYOUT - KEY

K.D. Drafting Ltd.
HERITAGE RECORDING
10815 – 128 STREET
EDMONTON ALBERTA CANADA
T5M 0W3
PHONE/FAX: 780.454.5155 C 238.5155
E-MAIL: kddrafting@telus.net

REVISIONS & ISSUES

NO.	DATE	DESCRIPTION	BY
01	09/24/09	ISSUED FOR REVIEW	KD

FIELD NOTES TAKEN
September 2009

DRAWN K. Dombrosky
CHK'D B. Hogan
SCALE:
HOR.
VER.

Yukon
Tourism and Culture
Historic Sites Unit

ELSA

BUILDING #12
BUNKHOUSE
(11 Bedrooms)

1st FLOOR PLAN

Sheet
OF
Consultant Dwg No.: A2.12
Y.T.G. Drawing No.:
REV.

Filename: D:\Data\Historic Site Current Work (KD01)\+Historic Sites Word documents\08-Elsa, Yukon - 2009\November 7-09 Final Submittal\+Elsa Sheets-DWG format- November 7-09\DS-Elsa A2-12.dwg Date: 11/7/2009



SOUTH EXTERIOR ELEVATION

0 1 2 3 4
SCALE BAR (Meters)




WEST EXTERIOR ELEVATION

0 1 2 3
SCALE BAR (Meters)




EAST EXTERIOR ELEVATION

0 1 2 3
SCALE BAR (Meters)

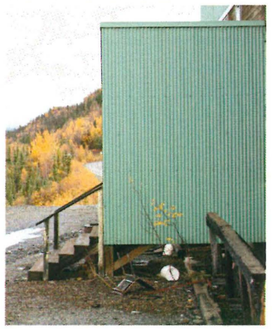

0 .5 1
SCALE BAR (Meters)

WEST ELEVATION OF NORTH ENTRY

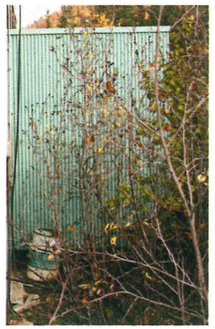

0 .5 1
SCALE BAR (Meters)

WEST ELEVATION OF SOUTH ENTRY



0 .5 1
SCALE BAR (Meters)


EAST ELEVATION OF SOUTH ENTRY



0 .5 1
SCALE BAR (Meters)

EAST ELEVATION OF NORTH ENTRY

NOTES/REFERENCE DRAWINGS

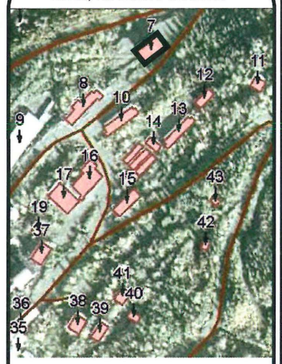

SITE LAYOUT - KEY

K.D. Drafting Ltd.
HERITAGE RECORDING
10815 - 129 STREET
EDMONTON ALBERTA CANADA
T5M 0W3
PHONE/FAX: 780.454.5155 C 238.5155
E-MAIL: kddrafting@telus.net

REVISIONS & ISSUES

NO.	DATE	DESCRIPTION	BY
01	09/24/09	ISSUED FOR REVIEW	KD

FIELD NOTES TAKEN
September 2009

DRAWN
K. Dombrosky

CHK'D
B. Hogan

SCALE:
HOR.
VER.

Yukon
Tourism and Culture
Historic Sites Unit

ELSA

BUILDING #7
NEW BUNKHOUSE

EXTERIOR
ELEVATIONS

Sheet
OF

Consultant Dwg No.: A3.7

Y.T.G. Drawing No.: REV.

Filename: D:\Data\Historic Sites Current Work (KD)\14 Macks Elbo Ward documents\Elbo Elsa - 2009\November 7-09 Final Submittal\Elbo Elsa-DWG format- November 7-09\04-Elbo A3-7 and A3-8.dwg Date: 11/7/2009



SOUTH EXTERIOR ELEVATION

0 1 2 3
SCALE BAR (Meters)



EAST EXTERIOR ELEVATION


0 1 2 3
SCALE BAR (Meters)



WEST EXTERIOR ELEVATION

0 1 2 3
SCALE BAR (Meters)

NOTES/REFERENCE DRAWINGS

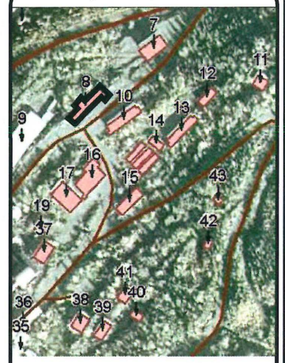

SITE LAYOUT - KEY

K.D. Drafting Ltd.
HERITAGE RECORDING
10815 - 128 STREET
EDMONTON ALBERTA CANADA
T5M 0W3
PHONE/FAX: 780.454.5155 C 238.5155
E-MAIL: kddrafting@telus.net

REVISIONS & ISSUES

NO.	DATE	DESCRIPTION	BY
01	09/24/09	ISSUED FOR REVIEW	KD

FIELD NOTES TAKEN: September 2009
DRAWN: K. Dombrosky
CHK'D: B. Hogan
SCALE:
HOR.
VER.

Yukon
Tourism and Culture
Historic Sites Unit

ELSA

BUILDING #8
GEOLOGY OFFICE

EXTERIOR
ELEVATIONS

Sheet
OF
Consultant Dwg No.: A3.8
Y.T.G. Drawing No.:
REV.

Filename: D:\Data\Historic Site Current Work (YG)\111-Historic Sites Word documents\26-Files, Yukon - 2009\November 7-09 Final Submittal\Site Sheets-2\W3 Sample - November 7-2009-Elsa-A3-2 and A3-4.dwg Date: 11/7/2009



NORTH EXTERIOR ELEVATION

0 1 2 3 4
SCALE BAR (Meters)



EAST EXTERIOR ELEVATION


0 1 2 3 4
SCALE BAR (Meters)



WEST EXTERIOR ELEVATION

0 1 2 3 4
SCALE BAR (Meters)

NOTES/REFERENCE DRAWINGS

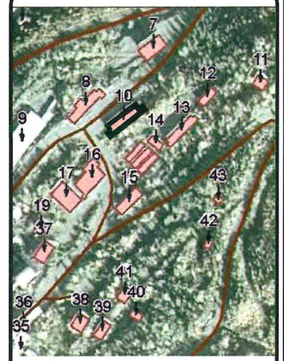

SITE LAYOUT - KEY

K.D. Drafting Ltd.
HERITAGE RECORDING
10815 - 128 STREET
EDMONTON ALBERTA CANADA
T5M 0W3
PHONE/FAX: 780.454.5155 C 238.5155
E-MAIL: kddrafting@telus.net

REVISIONS & ISSUES

NO.	DATE	DESCRIPTION	BY
01	09/24/09	ISSUED FOR REVIEW	KD

FIELD NOTES TAKEN
September 2009

DRAWN
K. Dombrosky

CHK'D
B. Hogan

SCALE:
HOR.
VER.

Yukon
Tourism and Culture
Historic Sites Unit

ELSA

BUILDING #10
#5 BUNKHOUSE


EXTERIOR
ELEVATIONS

Sheet
OF

Consultant Dwg No.: A3.10

Y.T.G. Drawing No.: REV.

Filename: D:\Data\Historic Site Current Work (KDD)\11-Historic Sites Word documents\09-Elsa, Yukon - 2009\November 7-09\5 Final Submittals\Elsa Sheets\2009 Bunk - November 7-09\05-Elsa A3-10 and A3-12.dwg Date: 11/7/2009

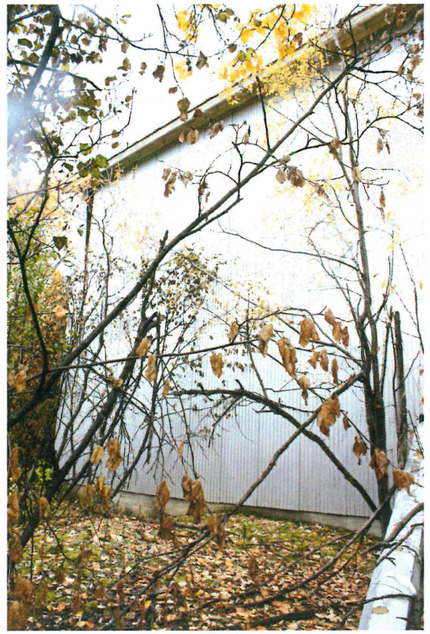


NORTH EXTERIOR ELEVATION - LEFT SIDE




NORTH EXTERIOR ELEVATION - RIGHT SIDE




WEST EXTERIOR ELEVATION

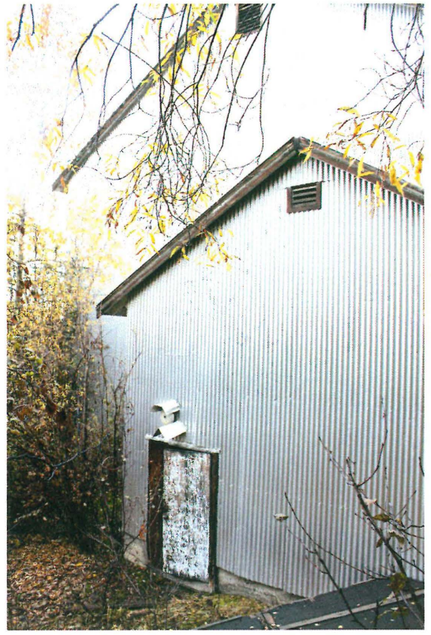

WEST EXTERIOR ELEVATION

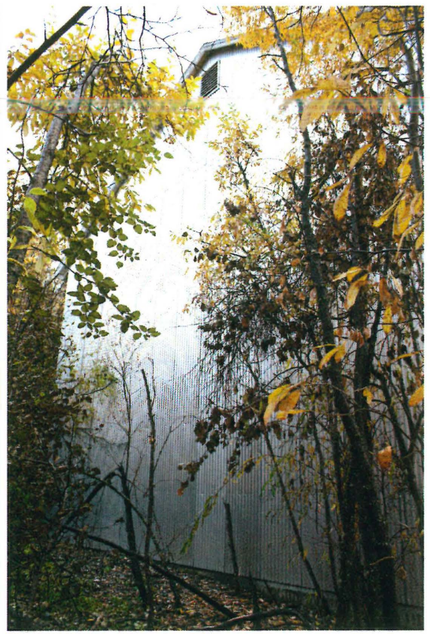

EAST EXTERIOR ELEVATION

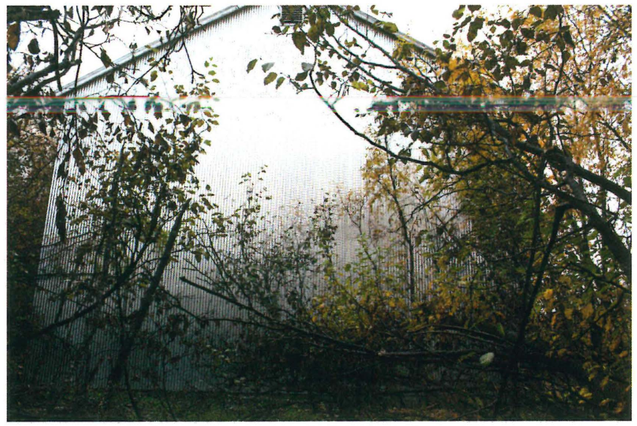

EAST EXTERIOR ELEVATION




SOUTH EXTERIOR ELEVATION



SOUTH EXTERIOR ELEVATION

NOTES/REFERENCE DRAWINGS

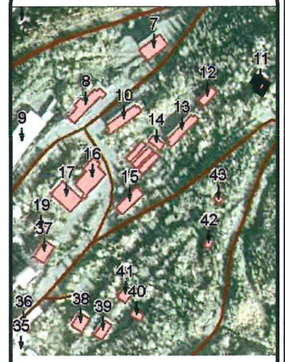

SITE LAYOUT - KEY

K.D. Drafting Ltd.
HERITAGE RECORDING
10815 – 128 STREET
EDMONTON ALBERTA CANADA
T5M 0W3
PHONE/FAX: 780.454.5155 C 238.5155
E-MAIL: kddrafting@telus.net

REVISIONS & ISSUES

NO.	DATE	DESCRIPTION	BY
01	09/24/09	ISSUED FOR REVIEW	KD

FIELD NOTES TAKEN
September 2009

DRAWN
K. Dombrosky

CHK'D
B. Hogan

SCALE:
HOR.
VER.

Yukon
Tourism and Culture
Historic Sites Unit

ELSA

BUILDING #11
UTILITY BUILDING

EXTERIOR
ELEVATIONS

Sheet
OF

Consultant Dwg No.: A3.11

Y.T.G. Drawing No.: REV.

Plotted: D:\Data\Historic Site Current Work (KDD)\11-Historic Sites Word documents\05-Elsa, Yukon - 2009\November 7-09 Final Submittal\11-Elsa Bldgs DWG format- November 7-09\05-Elsa Bld. No.11.dwg Date: 11/7/2009



NORTH EXTERIOR ELEVATION

0 1 2 3
SCALE BAR (Meters)



EAST EXTERIOR ELEVATION


0 1 2 3
SCALE BAR (Meters)



WEST EXTERIOR ELEVATION

0 1 2 3
SCALE BAR (Meters)

NOTES/REFERENCE DRAWINGS

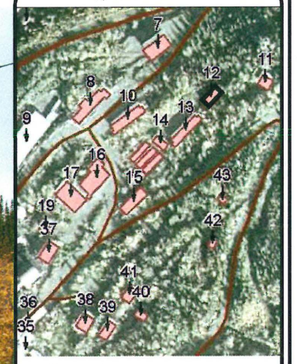

SITE LAYOUT - KEY

K.D. Drafting Ltd.
HERITAGE RECORDING
10815 – 128 STREET
EDMONTON ALBERTA CANADA
T5M 0W3
PHONE/FAX: 780.454.5155 C 238.5155
E-MAIL: kddrafting@telus.net

REVISIONS & ISSUES

NO.	DATE	DESCRIPTION	BY
01	09/24/09	ISSUED FOR REVIEW	KD

FIELD NOTES TAKEN
September 2009

DRAWN
K. Dombrosky

CHK'D
B. Hogan

SCALE:
HOR.
VER.

Yukon
Tourism and Culture
Historic Sites Unit

ELSA

BUILDING #12
BUNKHOUSE

EXTERIOR
ELEVATIONS

Sheet
OF

Consultant Dwg No.: A3.12

Y.T.G. Drawing No.:

REV.

Pathname:D:\Data\Work\Elsa Cores\Work 2009\11-Hacks (Elsa Word documents)\Elsa Bldgs-2009\November 7-09\Final Submittal\11-Elsa Bldgs-2009 format November 7-09\05-Elsa A3-12.dwg Date: 11/7/2009



NORTH EXTERIOR ELEVATION

SCALE BAR (Meters) 0 1 2 3



EAST EXTERIOR ELEVATION

SCALE BAR (Meters) 0 1 2 3



WEST EXTERIOR ELEVATION

SCALE BAR (Meters) 0 1 2 3

NOTES/REFERENCE DRAWINGS



SITE LAYOUT - KEY

K.D. Drafting Ltd.
HERITAGE RECORDING
10815 – 128 STREET
EDMONTON ALBERTA CANADA
T5M 0W3
PHONE/FAX: 780.454.5155 C 238.5155
E-MAIL: kddrafting@telus.net

REVISIONS & ISSUES

NO.	DATE	DESCRIPTION	BY
01	09/24/09	ISSUED FOR REVIEW	KD

FIELD NOTES TAKEN: September 2009

DRAWN: K. Dombrosky

CHK'D: B. Hogan

SCALE: HOR. VER.

Yukon
Tourism and Culture
Historic Sites Unit

ELSA

BUILDING #13
NO. 1 BUNKHOUSE

EXTERIOR ELEVATIONS

Sheet OF

Consultant Dwg No.: A3.13

Y.T.G. Drawing No.: REV.

Filename: D:\Data\Work\Elsa\Elsa Current Work\2009\13-Historic Sites Work\documents\09-Elsa, Yukon - 2009\November 7-09 Final Submittal\Elsa Sheets-DWG format- November 7-09\07-Elsa 13-13 ext A3-14.dwg Date: 11/7/2009




WEST EXTERIOR ELEVATION

0 1 2 3
SCALE BAR (Meters)



NORTH EXTERIOR ELEVATION

0 1 2 3
SCALE BAR (Meters)

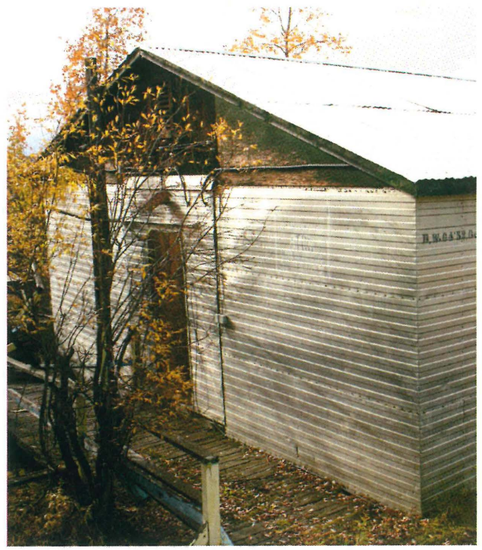


SOUTH EXTERIOR ELEVATION



EAST EXTERIOR ELEVATION

NOTES/REFERENCE DRAWINGS

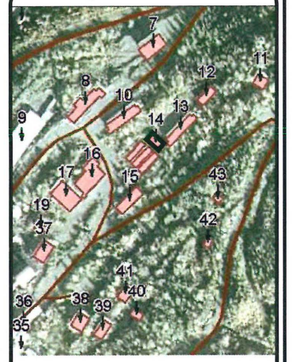

SITE LAYOUT - KEY

K.D. Drafting Ltd.
HERITAGE RECORDING
10815 - 128 STREET
EDMONTON ALBERTA CANADA
T5M 0W3
PHONE/FAX: 780.454.5155 C 238.5155
E-MAIL: kddrafting@telus.net

REVISIONS & ISSUES

NO.	DATE	DESCRIPTION	BY
01	09/24/09	ISSUED FOR REVIEW	KD

FIELD NOTES TAKEN
September 2009

DRAWN
K. Dombrosky

CHK'D
B. Hogan

SCALE:
HOR.
VER.

Yukon
Tourism and Culture
Historic Sites Unit

ELSA

BUILDING #14
UNION SHOP

EXTERIOR
ELEVATIONS

Sheet
OF

Consultant Dwg No.: A3.14

Y.T.G. Drawing No.:

REV.

Plotted: 07-Dec-09 11:49 | By: Kevin Dombrosky



NORTH EXTERIOR ELEVATION

SCALE BAR (Meters) 0 1 2 3



WEST EXTERIOR ELEVATION


SCALE BAR (Meters) 0 1 2 3



EAST EXTERIOR ELEVATION

SCALE BAR (Meters) 0 1 2 3

NOTES/REFERENCE DRAWINGS

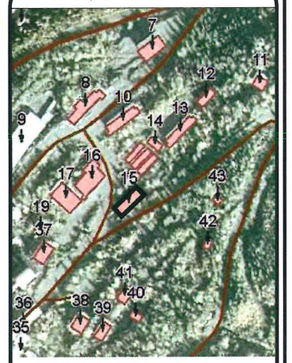

SITE LAYOUT - KEY

K.D. Drafting Ltd.
HERITAGE RECORDING
10815 – 128 STREET
EDMONTON ALBERTA CANADA
T5M 0W3
PHONE/FAX: 780.454.5155 C 238.5155
E-MAIL: kddrafting@telus.net

REVISIONS & ISSUES

NO.	DATE	DESCRIPTION	BY
01	09/24/09	ISSUED FOR REVIEW	KD

FIELD NOTES TAKEN
September 2009

DRAWN
K. Dombrosky

CHK'D
B. Hogan

SCALE:
HOR.
VER.

Yukon
Tourism and Culture
Historic Sites Unit

ELSA

BUILDING #15
SNACK BAR

EXTERIOR
ELEVATIONS

Sheet
OF

Consultant Dwg No.: A3.15

Y.T.G. Drawing No.:

REV.

Filename: D:\Data\Projects\Elsa Clean\Work\2009\11\Historic Elsa Word documents\08 Elsa, Yukon - 2009\November 7 09 Final Submittal\1 Elsa Sheets\DWG\Issue November 7 09\08 Elsa A3.15 to A3.17.dwg Date: 11/7/2009



SOUTH EXTERIOR ELEVATION

0 1 2 3
SCALE BAR (Meters)



EAST EXTERIOR ELEVATION

0 1 2 3
SCALE BAR (Meters)



NORTH EXTERIOR ELEVATION


0 1 2 3
SCALE BAR (Meters)



NORTH EXTERIOR ELEVATION

0 1 2 3
SCALE BAR (Meters)

NOTES/REFERENCE DRAWINGS

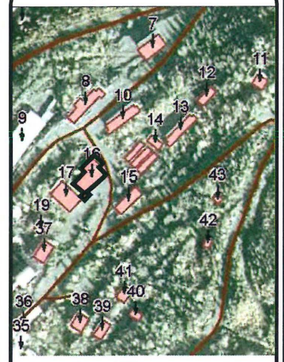

SITE LAYOUT - KEY

K.D. Drafting Ltd.
HERITAGE RECORDING
10815 - 128 STREET
EDMONTON ALBERTA CANADA
T5M 0W3
PHONE/FAX: 780.454.5155 C 238.5155
E-MAIL: kddrafting@telus.net

REVISIONS & ISSUES

NO.	DATE	DESCRIPTION	BY
01	09/24/09	ISSUED FOR REVIEW	KD

FIELD NOTES TAKEN: September 2009
DRAWN: K. Dombrosky
CHK'D: B. Hogan
SCALE: HOR.
VER.

Yukon
Tourism and Culture
Historic Sites Unit

ELSA

BUILDING #16
DINING HALL

EXTERIOR ELEVATIONS

Sheet OF
Consultant Dwg No.: A3.16
Y.T.G. Drawing No.: REV.


Filename: D:\Data\Historic Site Current Work (KDD)\1-Historic Sites Word documents\06-Elsa, Yukon - 2009\Newsletter 7-09 Final Submittal\1-Elsa Sheets-DWG format- November 7-09\06-Elsa A3-16 to A3-17.dwg Date: 11/7/2009



SOUTH EXTERIOR ELEVATION

SCALE BAR (Meters) 0 1 2 3

NOTES/REFERENCE DRAWINGS

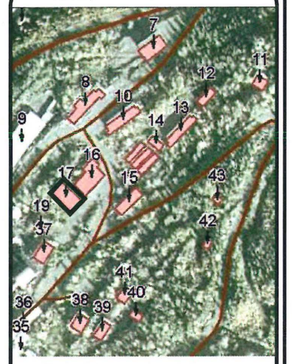

SITE LAYOUT - KEY

K.D. Drafting Ltd.
HERITAGE RECORDING
10815 - 126 STREET
EDMONTON ALBERTA CANADA
T5M 0W3
PHONE/FAX: 780.454.5155 C 238.5155
E-MAIL: kddrafting@telus.net

REVISIONS & ISSUES

NO.	DATE	DESCRIPTION	BY
01	09/24/09	ISSUED FOR REVIEW	KD

FIELD NOTES TAKEN
September 2009

DRAWN
K. Dombrosky

CHK'D
B. Hogan

SCALE:
HOR.
VER.

Yukon
Tourism and Culture
Historic Sites Unit

ELSA

BUILDING #17
DRY/CHANGE BLDG

EXTERIOR
ELEVATIONS

Sheet
OF

Consultant Dwg No.: A3.17

Y.T.G. Drawing No.:

REV.

Plotted: D:\Client\Historic Site Current Work (2009)\14-Historic Sites Work documents\09-Elsa, Yukon - 2009\November 7-09 Final Submittal\Elsa Sheets (DWG format- November 7-09)\05-Elsa 3-5 to 3-17.dwg Date: 11/7/2009



SOUTH EXTERIOR ELEVATION

0 1 2 3

SCALE BAR (Meters)




EAST EXTERIOR ELEVATION

0 1 2 3

SCALE BAR (Meters)

NOTES/REFERENCE DRAWINGS

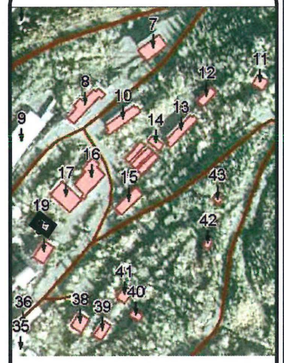

SITE LAYOUT - KEY

K.D. Drafting Ltd.
HERITAGE RECORDING
10815 – 128 STREET
EDMONTON ALBERTA CANADA
T5M 0W3
PHONE/FAX: 780.454.5155 C 238.5155
E-MAIL: kddrafting@telus.net

REVISIONS & ISSUES

NO.	DATE	DESCRIPTION	BY
01	09/24/09	ISSUED FOR REVIEW	KD

FIELD NOTES TAKEN
September 2009

DRAWN
R. Dombrosky

CHK'D
B. Hogan

SCALE:
HOR.
VER.

Yukon
Tourism and Culture
Historic Sites Unit

ELSA

BUILDING #19
FIRE ASSAY OFFICE

EXTERIOR
ELEVATIONS

Sheet
OF

Consultant Dwg No.: A3.19

Y.T.G. Drawing No.:

REV.

YUKON ENERGY, MINES
& RESOURCES LIBRARY
P.O. Box 2703 (K-335)
Whitehorse, Yukon Y1A 2C6

Plotted: D:\Data\Historic Site Current Work\FY2010\1-Historic Sites Work Documents\20-Elsa, Yukon - 2009\November 7-09 Final Submittal\Cad Files\Elsa-2009.dwg Saved: November 7-2009 Plot: A3-19 by A3-Sidney Date: 11/7/2009



EAST EXTERIOR ELEVATION


0 1 2 3
SCALE BAR (Meters)



WEST EXTERIOR ELEVATION

0 1 2 3
SCALE BAR (Meters)

NOTES/REFERENCE DRAWINGS

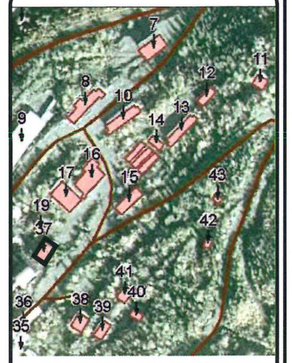

SITE LAYOUT - KEY

K.D. Drafting Ltd.
HERITAGE RECORDING
10815 - 128 STREET
EDMONTON ALBERTA CANADA
T5M 0W3
PHONE/FAX: 780.454.5155 C 238.5155
E-MAIL: kddrafting@telus.net

REVISIONS & ISSUES

NO.	DATE	DESCRIPTION	BY
01	09/24/09	ISSUED FOR REVIEW	KD

FIELD NOTES TAKEN
September 2009

DRAWN
K. Dombrosky

CHK'D
B. Hogan

SCALE:
HOR.
VER.

Yukon
Tourism and Culture
Historic Sites Unit

ELSA

BUILDING #37
ASSAY LAB

EXTERIOR
ELEVATIONS

Sheet
OF

Consultant Dwg No.: A3.37

Y.T.G. Drawing No.: REV.

Filename: D:\Client\Historic Site Current Work (2009)\14 Historic Sites Word documents\05 Elsa, Yukon - 2009\November 7 09 Final Submittal\ Elsa Bldg#37 Exterior November 7 2009.dwg Dwg Date: 11/7/2009



NORTH EXTERIOR ELEVATION

0 1 2 3
SCALE BAR (Meters)




EAST EXTERIOR ELEVATION

0 1 2 3
SCALE BAR (Meters)



WEST EXTERIOR ELEVATION

NOTES/REFERENCE DRAWINGS

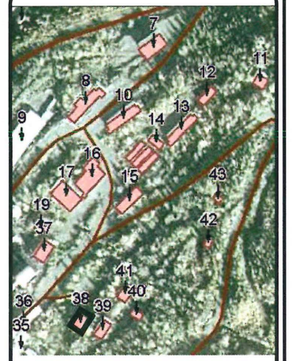

SITE LAYOUT - KEY

K.D. Drafting Ltd.
HERITAGE RECORDING
10815 - 128 STREET
EDMONTON ALBERTA CANADA
T5M 0W3
PHONE/FAX: 780.454.5155 C 238.5155
E-MAIL: kddrafting@telus.net

REVISIONS & ISSUES

NO.	DATE	DESCRIPTION	BY
01	09/24/09	ISSUED FOR REVIEW	KD

FIELD NOTES TAKEN
September 2009

DRAWN
K. Dombrosky

CHK'D
B. Hogan

SCALE:
HOR.
VER.

Yukon
Tourism and Culture
Historic Sites Unit

ELSA

BUILDING #38
ADMINISTRATION BLDG

EXTERIOR
ELEVATIONS

Sheet
OF

Consultant Dwg No.: A3.38

Y.T.G. Drawing No.:

REV.

Filename: D:\Client\Work\In Current Work (2009)\Historic Sites Work\Documents\Elsa, Yukon - 2009\November 7-09 Final Submittal\Elsa Bldg#38-2009 Exterior November 7-09.dwg Plotted: November 7, 2009 Plot Scale: 1:1 Plot Size: ANSI B (11.00 x 17.00 Inches) Date: 11/7/2009



EAST EXTERIOR ELEVATION




WEST EXTERIOR ELEVATION

0 1 2 3

SCALE BAR (Meters)

NOTES/REFERENCE DRAWINGS

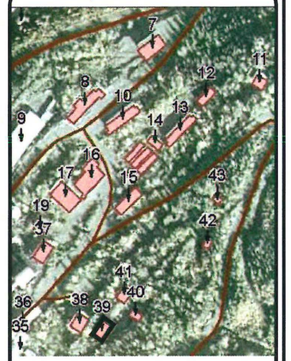

SITE LAYOUT - KEY

K.D. Drafting Ltd.
HERITAGE RECORDING
10815 - 128 STREET
EDMONTON ALBERTA CANADA
T5M 0W3
PHONE/FAX: 780.454.5155 C 238.5155
E-MAIL: kddrafting@telus.net

REVISIONS & ISSUES

NO.	DATE	DESCRIPTION	BY
01	09/24/09	ISSUED FOR REVIEW	KD

FIELD NOTES TAKEN: September 2009
DRAWN: K. Dombrosky
CHK'D: B. Hogan
SCALE: HOR. VER.

Yukon
Tourism and Culture
Historic Sites Unit

ELSA

BUILDING #39
STAFF OFFICE

EXTERIOR ELEVATIONS

Sheet OF
Consultant Dwg No.: A3.39
Y.T.G. Drawing No.: REV.

YUKON ENERGY, MINES
& RESOURCES LIBRARY
P.O. Box 2703 (K-335)
Whitehorse, Yukon Y1A 2C6




NORTH EXTERIOR ELEVATION



WEST EXTERIOR ELEVATION



NOTES/REFERENCE DRAWINGS

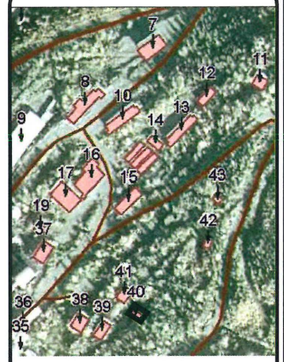

SITE LAYOUT - KEY

K.D. Drafting Ltd.
HERITAGE RECORDING
10815 – 128 STREET
EDMONTON ALBERTA CANADA
T5M 0W3
PHONE/FAX: 780.454.5155 C 238.5155
E-MAIL: kddrafting@telus.net

REVISIONS & ISSUES

NO.	DATE	DESCRIPTION	BY
01	09/24/09	ISSUED FOR REVIEW	KD

FIELD NOTES TAKEN
September 2009

DRAWN
K. Dombrosky

CHK'D
B. Hogan

SCALE:
HOR.
VER.

Yukon
Tourism and Culture
Historic Sites Unit

ELSA

BUILDING #40
GARAGE

EXTERIOR
ELEVATIONS

Sheet
OF

Consultant Dwg No.:
A3.40

Y.T.G. Drawing No.:

REV.

Plotted: D:\Data\Projects\Elsa Comet Work (YDC)\1-Hands (Elsa Work documents)\09 Elsa, Yukon - 2009\November 7 09\10 Final Submittal\1 Elsa Blends DWG\Arrow November 7 09\10-Elsa A3-40 by A3-40.dwg Date: 11/7/2009



SOUTH EXTERIOR ELEVATION

0 1 2 3
SCALE BAR (Meters)



WEST EXTERIOR ELEVATION


0 1 2 3
SCALE BAR (Meters)



WEST EXTERIOR ELEVATION

0 1 2 3
SCALE BAR (Meters)

NOTES/REFERENCE DRAWINGS

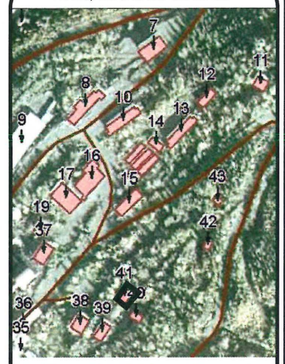

SITE LAYOUT - KEY

K.D. Drafting Ltd.
HERITAGE RECORDING
10815 – 128 STREET
EDMONTON ALBERTA CANADA
T5M 0W3
PHONE/FAX: 780.454.5155 C 238.5155
E-MAIL: kddrafting@telus.net

REVISIONS & ISSUES

NO.	DATE	DESCRIPTION	BY
01	09/24/09	ISSUED FOR REVIEW	KD

FIELD NOTES TAKEN
September 2009

DRAWN
K. Dombrosky

CHK'D
B. Hogan

SCALE:
HOR.
VER.

Yukon
Tourism and Culture
Historic Sites Unit

ELSA

BUILDING #41
APARTMENT BLDG

EXTERIOR
ELEVATIONS

Sheet
OF

Consultant Dwg No.: A3.41

Y.T.G. Drawing No.:

REV.

Filename: D:\Data\Historic Sites Correspondence\2009\Historic Sites Work documents\2009 Sites, Yukon - 2009\November 7-8\09-Elsa A3-41 to A3-43.dwg Date: 11/7/2009



EAST EXTERIOR ELEVATION

0 1 2 3

SCALE BAR (Meters)




NORTH EXTERIOR ELEVATION

0 1 2 3

SCALE BAR (Meters)

NOTES/REFERENCE DRAWINGS

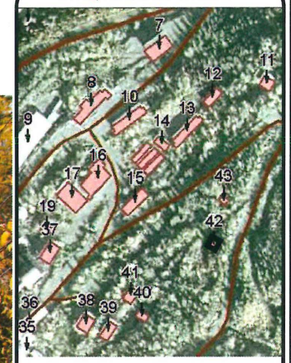

SITE LAYOUT - KEY

K.D. Drafting Ltd.
HERITAGE RECORDING
10815 - 128 STREET
EDMONTON ALBERTA CANADA
T5M 0W3
PHONE/FAX: 780.454.5155 C 238.5155
E-MAIL: kddrafting@telus.net

REVISIONS & ISSUES

NO.	DATE	DESCRIPTION	BY
01	09/24/09	ISSUED FOR REVIEW	KD

FIELD NOTES TAKEN: September 2009

DRAWN: K. Dombrosky

CHK'D: B. Hogan

SCALE: HOR. VER.

Yukon
Tourism and Culture
Historic Sites Unit

ELSA

BUILDING #42
GARAGE

EXTERIOR
ELEVATIONS

Sheet OF

Consultant Dwg No.: A3.42


Y.T.G. Drawing No.: REV.

Plotted: D:\Data\Work Do Current Work\2009\11 Kate's Blue Wall Documents\3 Dwg, Yukon 2009\Number 2 50 Pad Submittal Dwg Sheets\3D3 Saved: November 7 2009 3:39p A3-42 to A3-43.dwg Date: 11/7/2009



SOUTH EXTERIOR ELEVATION

SCALE BAR (Meters) 0 1 2 3

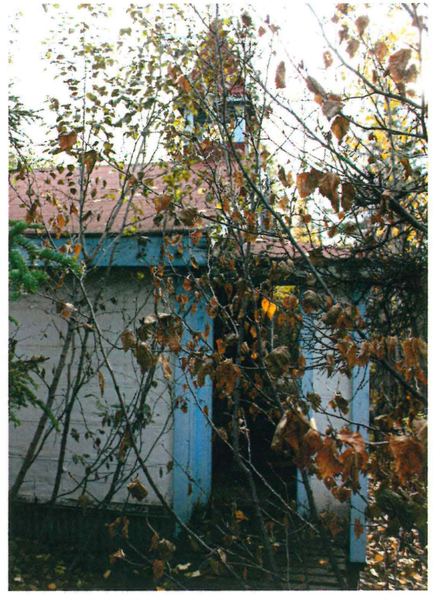

EAST EXTERIOR ELEVATION



NORTH EXTERIOR ELEVATION


SCALE BAR (Meters) 0 1 2 3



WEST EXTERIOR ELEVATION

SCALE BAR (Meters) 0 1 2

NOTES/REFERENCE DRAWINGS

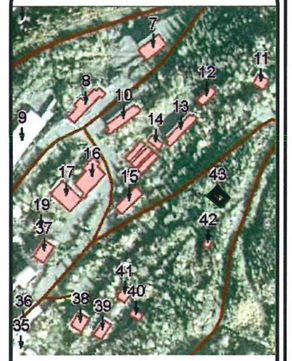

SITE LAYOUT - KEY

K.D. Drafting Ltd.
HERITAGE RECORDING
10815 – 128 STREET
EDMONTON ALBERTA CANADA
T5M 0W3
PHONE/FAX: 780.454.5155 C 238.5155
E-MAIL: kddrafting@telus.net

REVISIONS & ISSUES

NO.	DATE	DESCRIPTION	BY
01	09/24/09	ISSUED FOR REVIEW	KD

FIELD NOTES TAKEN September 2009

DRAWN K. Dombrosky

CHK'D B. Hogan

SCALE: HOR. VER.

Yukon
Tourism and Culture
Historic Sites Unit

ELSA

BUILDING #43
CHURCH

EXTERIOR ELEVATIONS

Sheet OF

Consultant Dwg No.: A3.43

Y.T.G. Drawing No.: REV.

Filename: D:\Data\Historic Site Current Work (PDF)\14 Historic Sites Word documents\09 Elsa, Yukon - 2009\November 7-09 Final Submittal\Elsa Sheets (CAD) format November 7-09\09-Elsa A3-43 to A3-45.dwg Date: 11/7/2009